

JOHNSTON COUNTY ENVIRONMENTAL HEALTH DEPARTMENT


205 South Second Street
Smithfield, North Carolina 27577
Telephone (919) 989-5180
IMPROVEMENT PERMIT

Application No.: 55031
Tax Map No.: 16K030300
Date: 10-23-00

Name: Edwards, Richard
Address: _____
Location: SL-1701 S/D Lot No.: B
Facility: Residential LTAR: _____
Bedrooms: 3 Design Daily Sewage Flow: 360 Lot area: ± .960 AC
New Construction: ✓ Repair: _____ Water Supply: Well
Soil/Site Classification: P2
Septic Tank Size: 1000 Grease Trap Size: _____
Pump Tank Size: N/A Pump(s) Size: N/A
Drainfield Type: Conv. Square Feet: 1081 sq'
No. Lines: 5 Width: 3' Length: 75' Depth: 20"
Design/Layout by: Jan Permit Issued By: R. Carroll
Inspection: Lines: Jan Septic Tank/Box: Jan
Pump Tank: _____ Pump(s)/Pressure: _____
Drainage: _____ Contractor: Tony Carroll

AUTHORIZATION FOR WASTEWATER SYSTEM CONSTRUCTION

ISSUED BY: Robert M. Hall DATE ISSUED: 10-23-00
By rule this septic system requires the use of an effluent filter and a waterproof seal. A riser and septic marker may also be required.

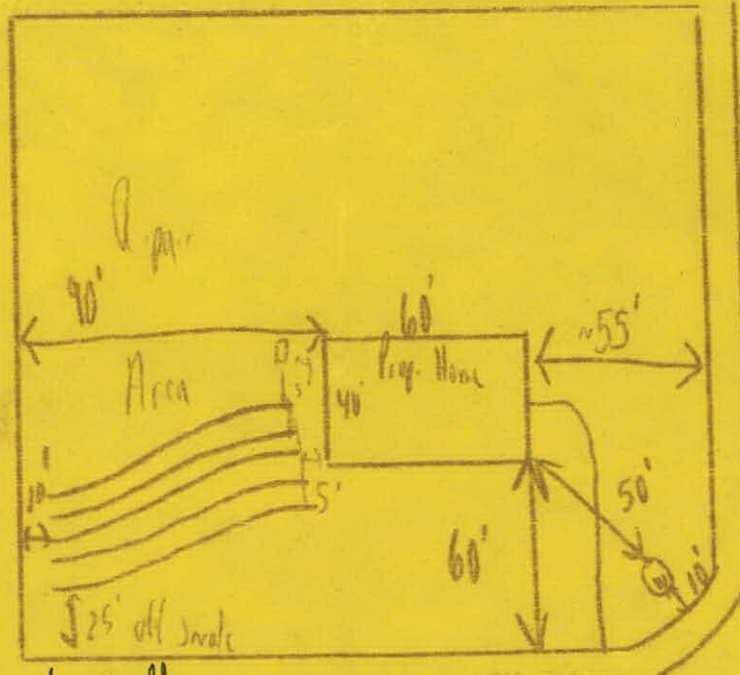

OPERATION PERMIT BY: Robert M. Hall DATE: 2-1-01
Systems shall be installed as shown in sketch or as on attached plans and specifications. Any unauthorized site disturbance, filling, soil removal, or layout changes may result in this permit being revoked. This authorization for wastewater system to construct is good for 5 years from date of issue.