

Environmental Services - Water Quality
Onsite Wastewater Scan Data Entry Form

PERMIT #: 8003991

PIN #: 1764583566

OP DATE: 0911211974

SYSTEM USE:

- ☒ House
☐ Mobile Home
☐ Business
☐ Other

SEWAGE TYPE:

- ☒ Domestic
☐ Industrial

PUMP/SIPHON?:

- ☐ Yes
☒ No

PRESSURE MANIFOLD:

- ☐ Yes
☒ No

SYSTEM TYPE:

- ☐ I
☒ II
☐ III
☐ IV
☐ V
☐ VI
☐ Other

SUB TYPE:

- ☒ A
☐ B
☐ C
☐ D
☐ E
☐ F
☐ G

NBR BEDROOMS:

- ☐ 1
☐ 2
☒ 3
☐ 4
☐ 5
☐ 6
☐ Other

MAINT. SCHEDULE:

- ☐ Yes
☒ No

CERT. OPERATOR

- ☐ Yes
☒ No

GT ST PT SIZE

- | | | | |
|-------------------------------------|-------------------------------------|-------------------------------------|------------------|
| ☐ | ☐ | | 750 |
| ☐ | ☐ | ☐ | 900 |
| ☐ | ☐ | ☐ | 1,000 |
| ☐ | ☒ | ☐ | 1,200 |
| ☐ | ☐ | ☐ | 1,500 |
| ☐ | ☐ | ☐ | 1,800 |
| ☐ | ☐ | ☐ | 2,100 |
| ☐ | ☐ | ☐ | 2,500 |
| ☐ | ☐ | ☐ | 3,000 |
| ☐ | ☐ | ☐ | 4,000 |
| ☐ | ☐ | ☐ | 5,000 |
| ☐ | ☐ | ☐ | 8,000 |
| ☐ | ☐ | ☐ | 10,000 |
| ☐ | ☐ | ☐ | Other |
| ☒ | | ☒ | None/NA GT or PT |

DRAINFIELD SIZE(SQ. FT.)

01200

DRAIN TYPE:

- ☒ Stone
☐ EZ Flow
☐ Infiltrator
☐ Biodiffuser
☐ Cultec
☐ Drip
☐ Hancor
☐ Large Dia. Pipe
☐ Multi-Pipe
☐ Other

MAX DEPTH (IN.):

- ☐ 12 in. or less
☐ 18 in. or less
☐ 24 in. or less
☐ 26 in. or less
☐ 28 in. or less
☐ 30 in. or less
☐ 32 in. or less
☐ 36 in. or less
☒ Other

STONE DEPTH (IN.):

- ☐ 8 in. or less
☒ 12 in. or less
☐ 18 in. or less
☐ 24 in. or less
☐ Other

TRENCHES:

- ☐ Individual
☒ Bed

TRENCH WIDTH (IN.):

- ☐ 12 in. or less
☐ 18 in.
☐ 24 in.
☐ 36 in.
☒ 6 ft. or less
☐ 9 ft. or less
☐ Other

CH

* PERMIT VOID IF NOT IN COMPLIANCE WITH ZONING REGULATIONS

WAKE COUNTY HEALTH DEPARTMENT
SEPTIC TANK LAYOUT AND PERMIT

PERMIT NO. **B 3991**

OWNER OR CONTRACTOR E. J. L. L.

DATE 4-3-74

LOCATION Highway 64 E corner of Oak Ridge Rd - W. side

S. R. NO. 2256

SUBDIVISION NAME Robin Hood Forest

LOT NO. 147

SECTION OR BLOCK NO.

GARBAGE DISPOSAL UNIT YES ☒ NO ☐

HOUSE ☒ MOBILE HOME ☐ BUSINESS ☐

NO. BEDROOMS 3 LOT AREA 40,000

SIZE OF TANK 1200 gal.


NITRIFICATION LINE (200' x 6') 1200 sq. ft.

DEPTH OF STONE IN LINES: 12" ☒ 18" ☐

WATER SUPPLY: INDIVIDUAL ☒ PUBLIC ☐

* PERMIT VOID 12 MONTHS FROM DATE OF ISSUANCE.

LAYOUT BY S. W. J. Smith

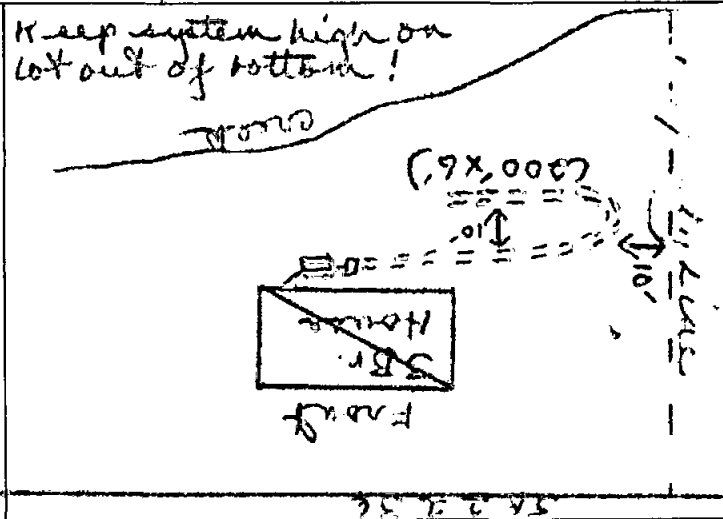

DATE 9-12-74

O. W. HeDrich
INSTALLED BY

James R. Proctor
APPROVED BY

[illegible]

PIN: 1764.02/-58-3566

Signature of Owner or Authorized Agent: Mary Lane

TABLE 29A. 701C (45)

0052950
1.37A
W001007

A hand-drawn sketch of a building layout. The sketch shows a rectangular building with internal divisions. Labels include "New BUILDING" in the top left, "5637" in the top right, "81 X 241" in the upper right, and "(214)" in the bottom right. Dimensions "161" and "38" are marked. Arrows point to specific areas. The sketch is drawn on a background with faint grid lines and other markings like "100", "200", "100", and "6".

Site plan submitted as shown for
Any changes to site plan voids approval for
for septic systems and wells, regarding any pools, decks,
additions and/or accessory structures. Applicant is responsible
for protecting all portions of the septic system, repair area and
wells from damage during construction. Adhere to all Local and
State Rules.
Approved by W. J. Keiths Rd. Date 4-11-01
Wick County Department of Environmental Services
Water and Waste Water Section

813 Kerths Rd.
Knightdale NC 27545

IMPERV. SURFACES
HOUSE 2304 SF
DRIVEWAY 2320 SF
PROP. S: Bldg 432 SF

TOTAL 5,056 SF