

Environmental Services - Water Quality
Onsite Wastewater Scan Data Entry Form

PERMIT #: **WA I 5 7 I 7**

PIN #: **I 6 I 8 8 5 8 4 I 2**

OP DATE: **0 5 / I 0 / 2 0 I 7**

SYSTEM USE:
☒ House
☐ Mobile Home
☐ Business
☐ Other

SEWAGE TYPE:
☒ Domestic
☐ Industrial

PUMP/SIPHON?:
☐ Yes
☒ No

PRESSURE MANIFOLD:
☐ Yes
☒ No

SYSTEM TYPE:
☐ I
☒ II
☐ III
☐ IV
☐ V
☐ VI
☐ Other

SUB TYPE:
☒ A
☐ B
☐ C
☐ D
☐ E
☐ F
☐ G

NBR BEDROOMS:
☐ 1
☐ 2
☒ 3
☐ 4
☐ 5
☐ 6
☐ Other

MAINT. SCHEDULE:
☐ Yes
☒ No

CERT. OPERATOR
☐ Yes
☒ No

GT	ST	PT	SIZE
☐	☐		750
☐	☐	☐	900
☐	☒	☐	1,000
☐	☐	☐	1,200
☐	☐	☐	1,500
☐	☐	☐	1,800
☐	☐	☐	2,100
☐	☐	☐	2,500
☐	☐	☐	3,000
☐	☐	☐	4,000
☐	☐	☐	5,000
☐	☐	☐	8,000
☐	☐	☐	10,000
☐	☐	☐	Other
☒		☒	None/NA GT or PT

DRAINFIELD SIZE(SQ. FT.)

0 I 0 0 0

DRAIN TYPE:

☒ Stone
☐ EZ Flow
☐ Infiltrator
☐ Biodiffuser
☐ Cultec
☐ Drip
☐ Hancor
☐ Large Dia. Pipe
☐ Multi-Pipe
☐ Other

MAX DEPTH (IN.):

☐ 12 in. or less
☐ 18 in. or less
☒ 24 in. or less
☐ 26 in. or less
☐ 28 in. or less
☐ 30 in. or less
☐ 32 in. or less
☐ 36 in. or less
☐ Other

STONE DEPTH (IN.):

☐ 8 in. or less
☒ 12 in. or less
☐ 18 in. or less
☐ 24 in. or less
☐ Other

TRENCHES:

☒ Individual
☐ Bed

TRENCH WIDTH (IN.):


☐ 12 in. or less
☐ 18 in.
☐ 24 in.
☒ 36 in.
☐ 6 ft. or less
☐ 9 ft. or less
☐ Other

MYB

Zoning R30 By osf
 Approve — Date 5/10/17
 Revise — Use 434D
 Reject — MBL 101A
 Front 30 Rear 30
 Side 10 Corner —
 Comments: Deck/Screen Porch

P.I.# 1618858412
 I certify that the location of planned or existing structure(s) are accurately shown. I understand failure to locate structures in accordance with this plot plan may require the relocation of structure(s) regardless degree of completion. I hereby grant permission to Municipal/County Representatives the right of entry to make evaluations or inspections upon this property.
[Signature]
 Signature of Owner or Authorized Agent

Site Plan
 1409 Turner Farms Rd
 Garner NC
 1"=40'

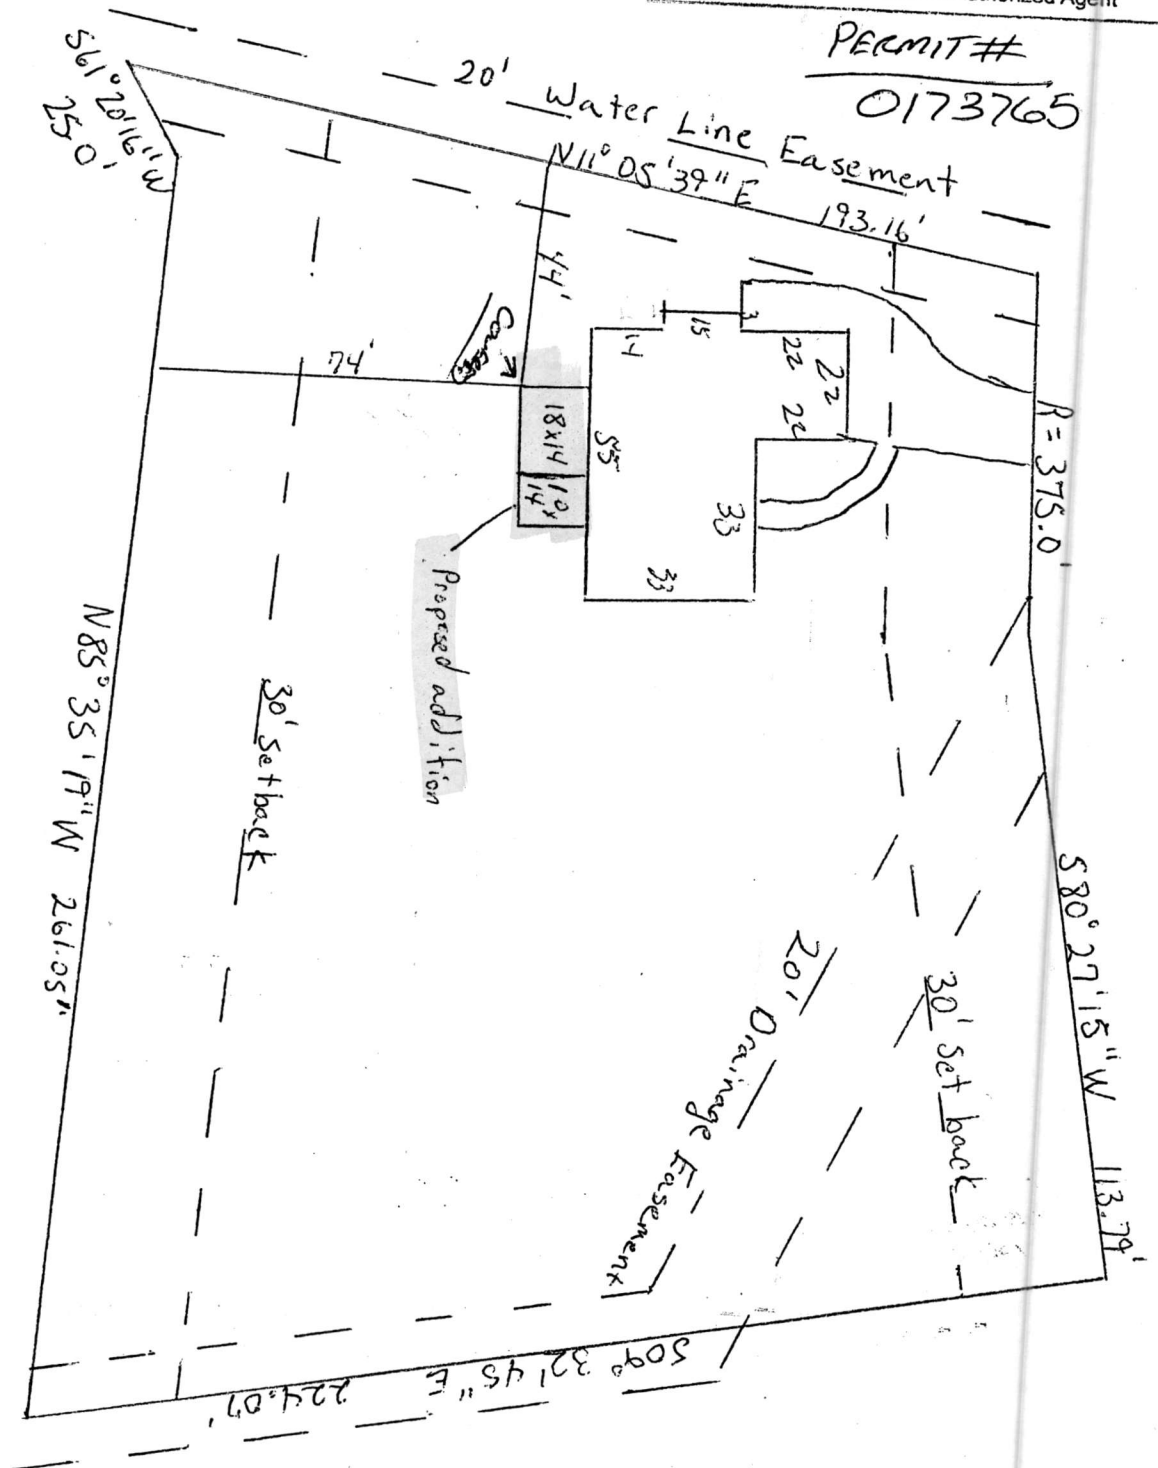

Site plan approved as shown for Screen Porch & Deck
 Any changes to site plan voids approval. All setbacks apply for septic systems and wells, regarding any pools, decks, additions and/or accessory structures. Applicant is responsible for protecting all portions of the septic system, repair area and wells from damage during construction. Adhere to all Local and State Rules.
 Approved by [Signature] Date 5-10-2017
 Wake County Department of Environmental Services.
 Water and Waste Water Section